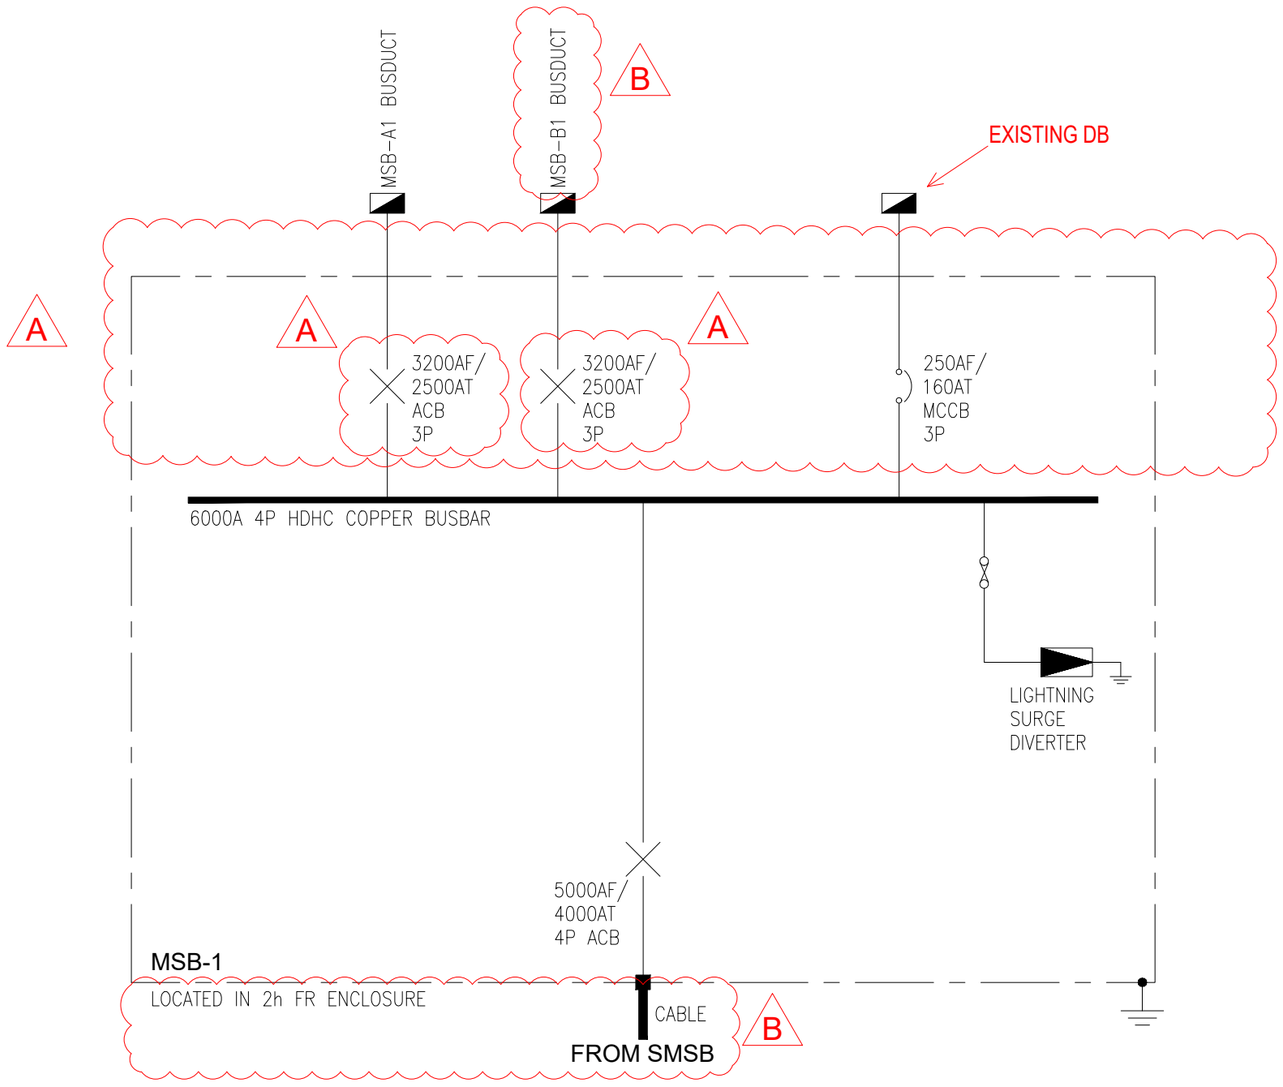

LEGEND:

ATS	AUTOMATIC TRANSFER SWITCH
ELR	EARTH LEAKAGE RELAY
E/F	EARTH FAULT PROTECTION RELAY
O/C	OVER-CURRENT PROTECTION RELAY
PQM	POWER QUALITY METER
ST	SHUNT-TRIP
UVR	UNDER VOLTAGE RELAY
	MCCB / MCB MOLDED CASE CIRCUIT BREAKER / MINIATURE CIRCUIT BREAKER
	RESIDUAL CURRENT CIRCUIT BREAKER
	AIR CIRCUIT BREAKER
L1 L2 L3	LED INDICATOR LIGHTS
	CURRENT TRANSFORMER
	FUSED
	DISTRIBUTION BOARD

SHEET SIZE A3

REF. DOCUMENT NUMBER	DOCUMENT TYPE	REV	REVISION COMMENT	DRAWN	CHECK'D	APPR'D	DATE
E203 SEP 18	DWG FROM AT	C	AS INSTALLED	MU	MU	RT	26.06.19
		B	UPDATED AS PER ALEX FIL/JUSTIN COMMENTS	RS	RS	RT	19.06.19
		C	FOR TCCF REVIEW	MU	MU	RT	16.07.19

DRAWN	R.STREET		7.06.19
CHECKED	R.STREET		7.06.19
ENG CHK APP	R.TAMILA		14.06.19
APPROVED	R.TAMILA		14.06.19

THE DATA EXCHANGE NETWORK LTD
9 MUMFORD PLACE
BALCATTA WA 6021

SHEET 1 OF 1

TITLE
DATA EXCHANGE FACILITY (SYDNEY)
5 PARKVIEW DRIVE, OLYMPIC PARK,
NSW 2127

DRAWING DESCRIPTION
ELECTRICAL SERVICES
SINGLE LINE DIAGRAM 4
MSB-1

PROJECT NUMBER
SYD01

SCALE
NTS

DRAWING NUMBER
E203-03

REV
C